


SCHEDULE B

Emergency Exit Only

North Property Line

West Property Line

East Property Line

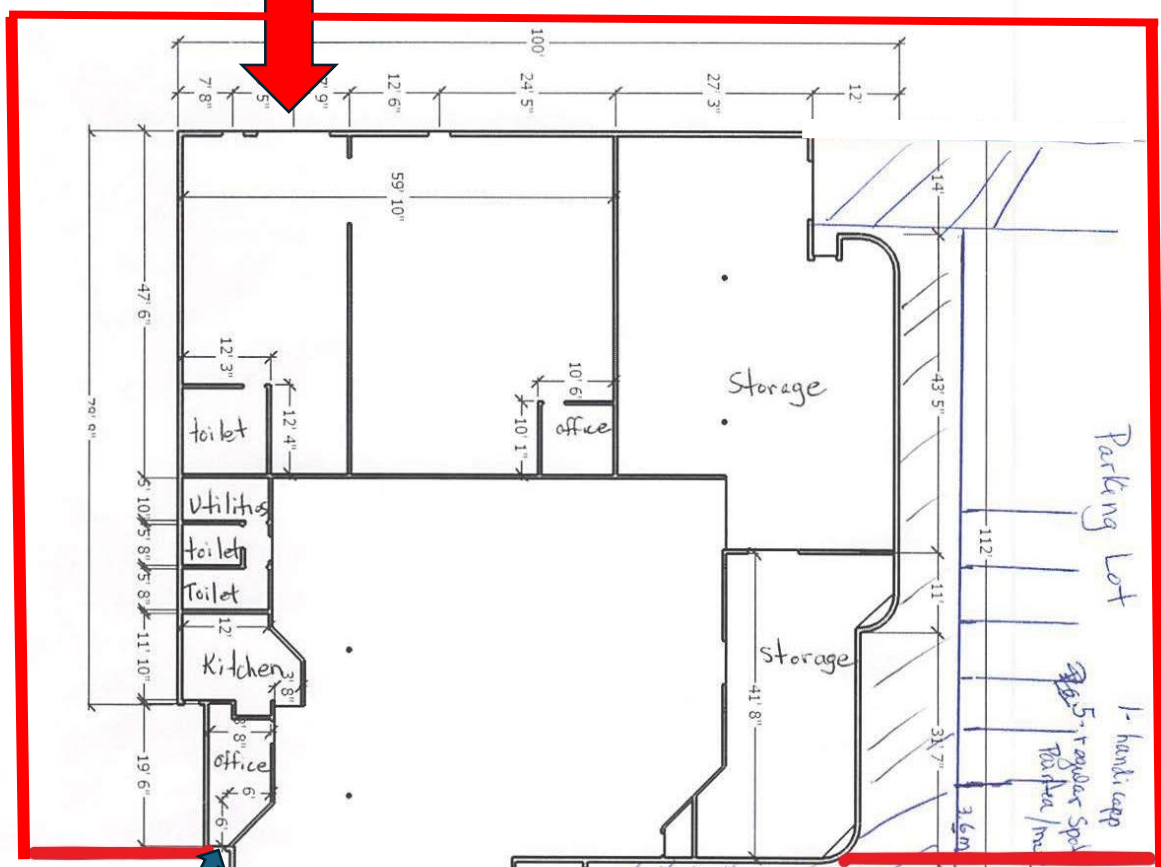

Red Lines - Fencing Required

South West Corner of Building

South East Corner of Building



1st ave

Development Permit No.: 048-2023

EXAMINED AND ISSUED

Date: 03/01/2024

Town of Edson Development Authority